


CAS BUILT

REFERENCE DRAWINGS	DWG. NUMBER

A

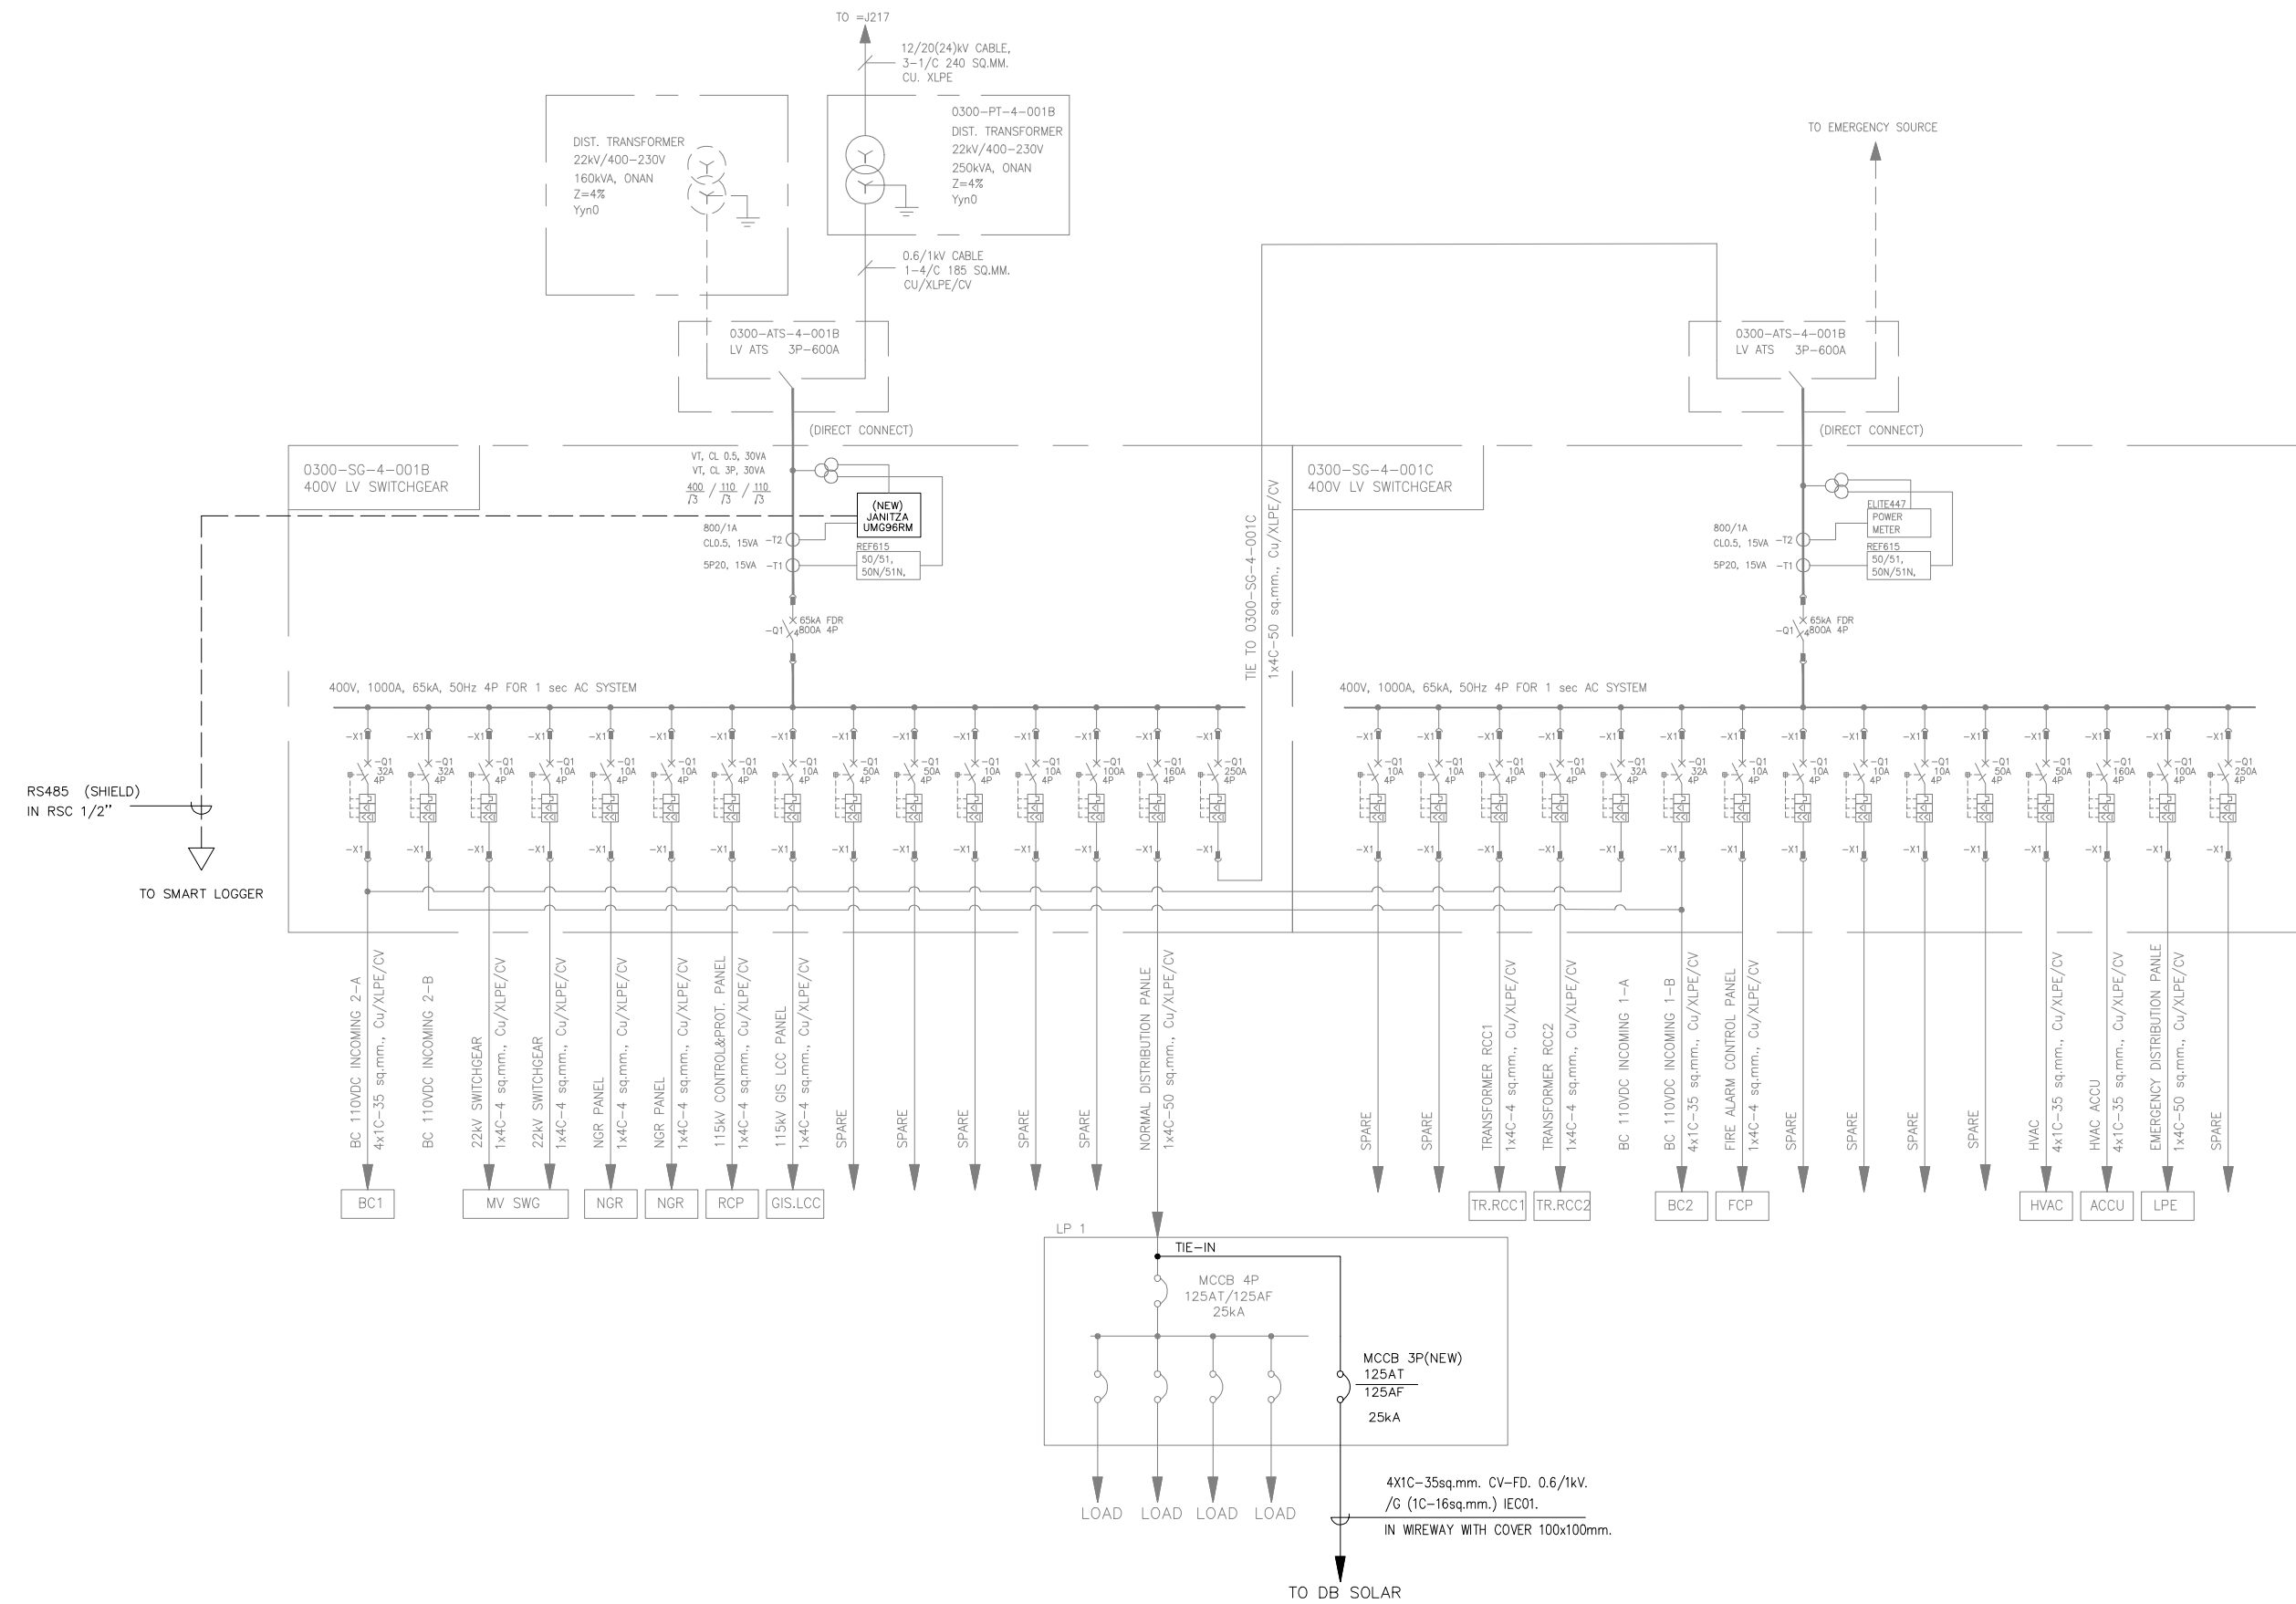

AS BUILT

R3	IFA	ISSUE FOR AS BUILT				08/12/2025
R2	IFR	ISSUE FOR REVIEW				01/01/2025
R1	IFR	ISSUE FOR REVIEW				09/06/2025
REV	STATUS	DESCRIPTION	BY	CHK.	APPR.	DATE



THIS DOCUMENT IS THE PROPERTY OF PAYAK POWER CORP WHO WILL SAFEGUARD ITS RIGHT
ACCORDING TO THE CIVIL AND PENAL PROVISION OF THE LAW.

FOR PTT LNG SOLAR ROOFTOP AT
ISB AND GIS SUBSTATIONS 200.20kW

TITLE
SOLAR SYSTEM SINGLE LINE DIAGRAM

EPCC	PROJ. NO.	DWG. NO.			SHEET
PTTLNG	PPA25.0008	PPA25.0008-PTTLNG-EE-001			2 OF 3
					REV. R3
DISCIP.		SIZE	A3	SCALE	NTS

A

B


C

A

B

C

SOLAR ROOFTOP AT GIS	
PV MODULE	TRINA, TSM-NEG21C.20(715 Wp), 84 PCS
INVERTER	HUAWEI, SUN2000-50KTL-M3(50kW), 1 UNIT
POWER OPTIMIZER	HUAWEI, MERC-1300W-P, 42 UNTIS
DC CAPACITIES	60.06 kWp.
DC/AC RATIO	1.20

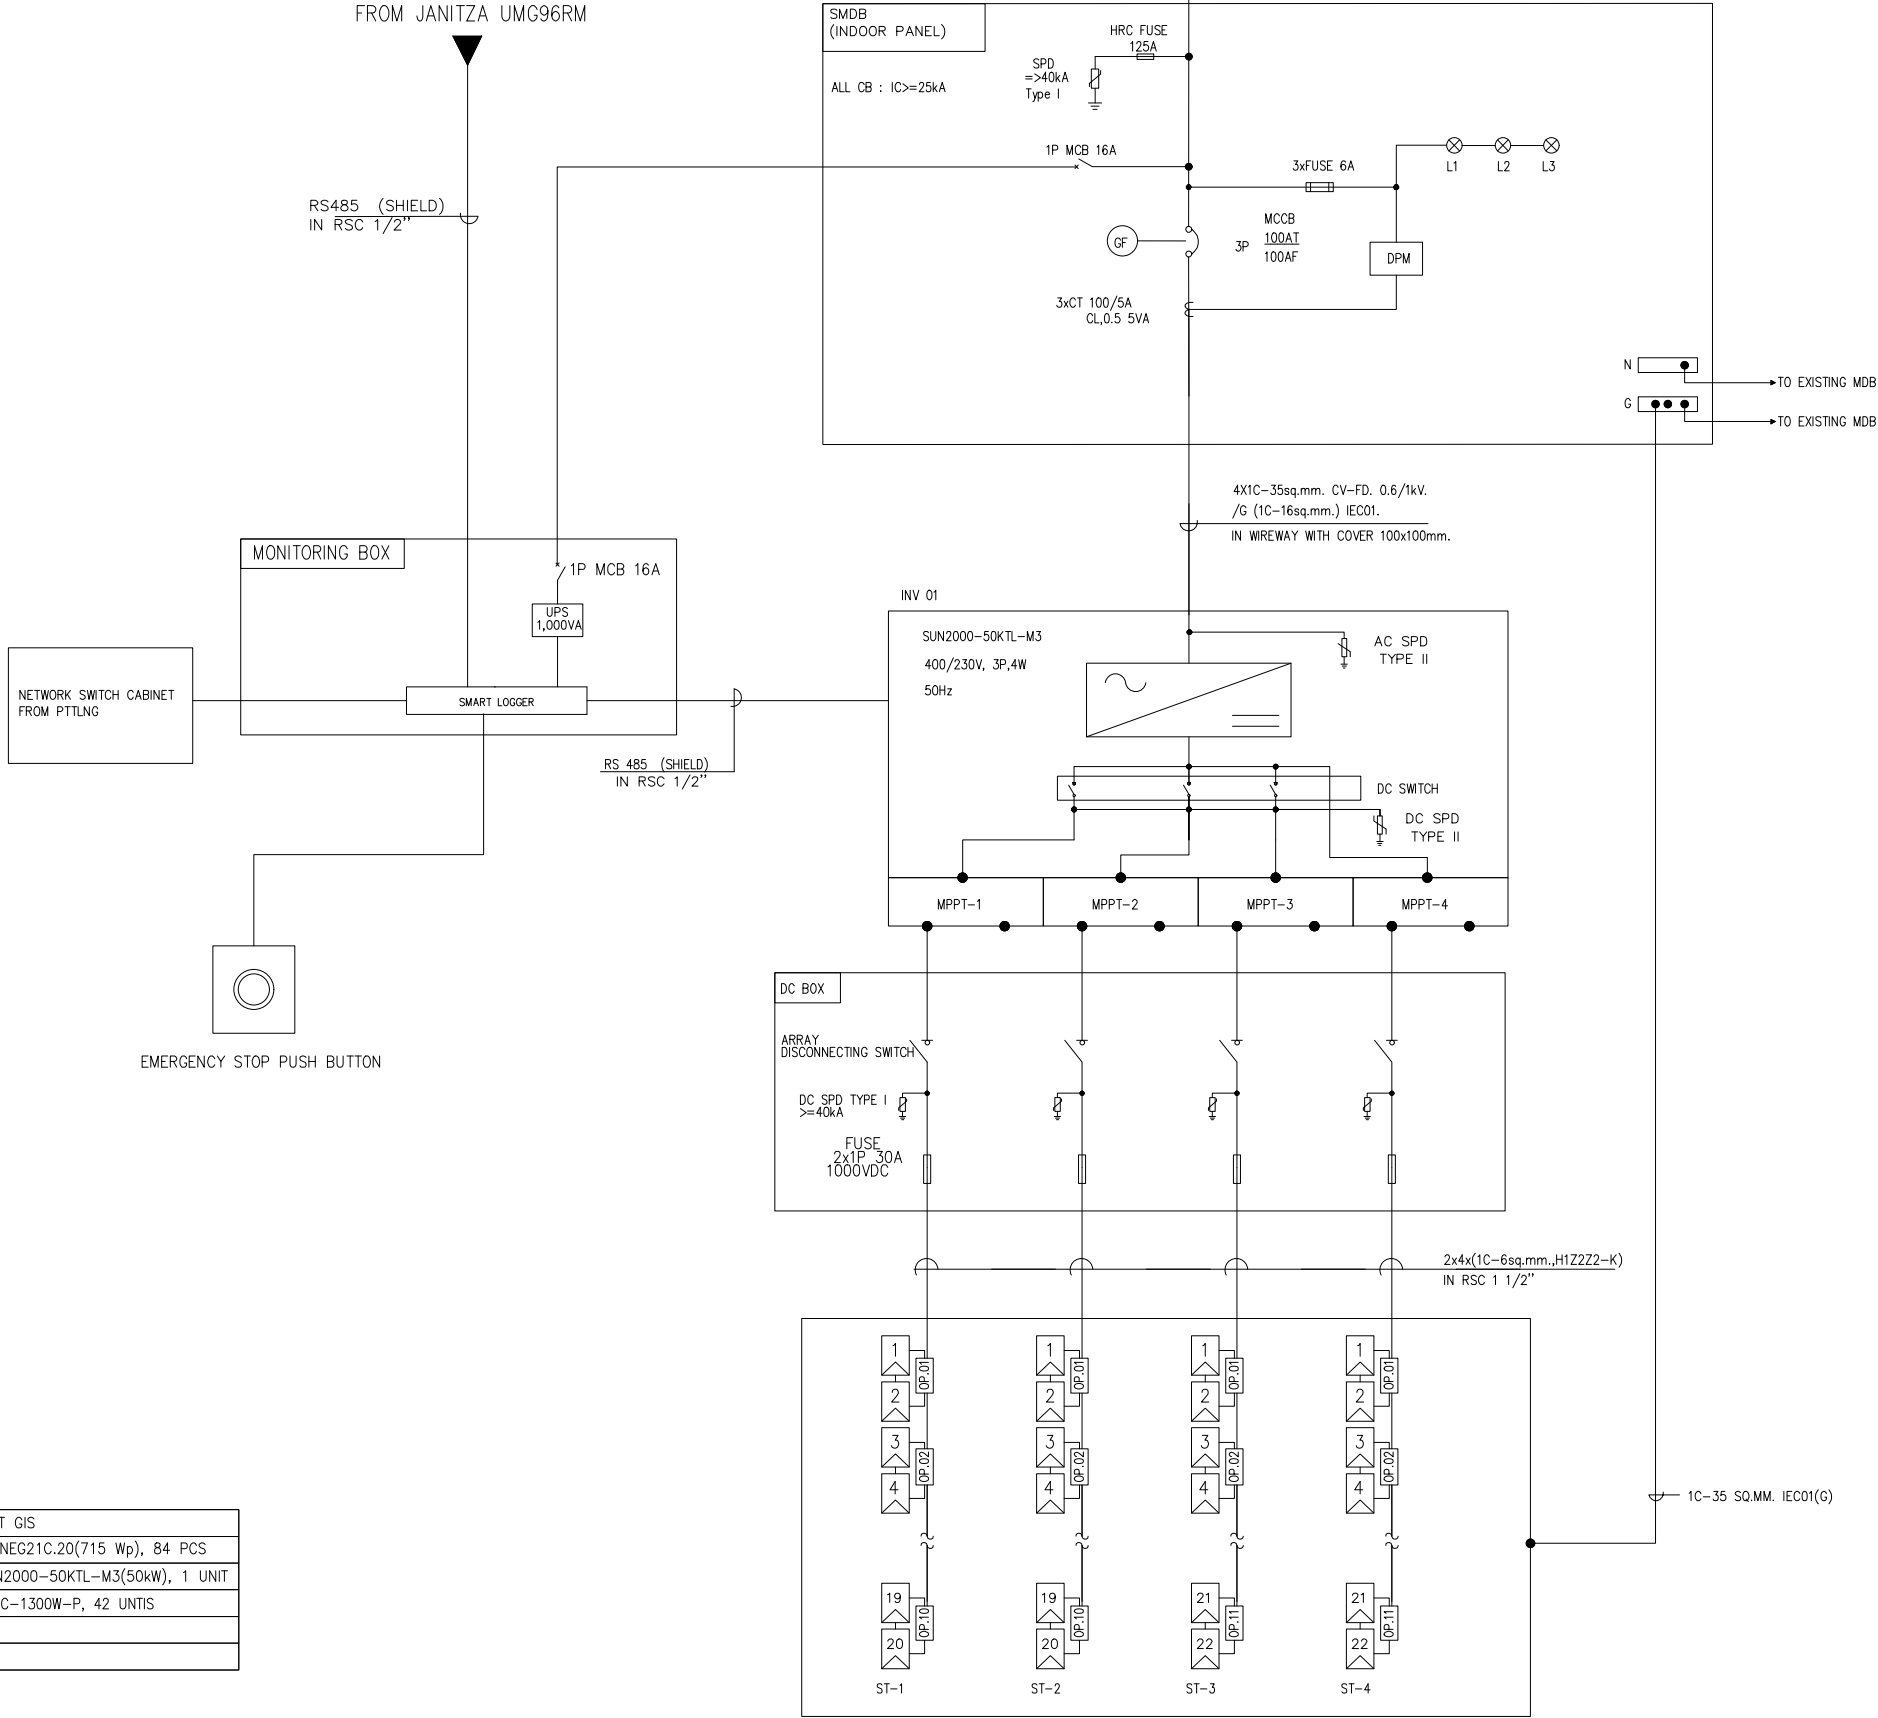

AS BUILT

REFERENCE DRAWINGS	DWG. NUMBER

REV.	STATUS	DESCRIPTION	BY	CHK.	APPR.	DATE
R3	IFA	ISSUE FOR AS BUILT				08/12/2025
R2	IFR	ISSUE FOR REVIEW				01/07/2025
R1	IFR	ISSUE FOR REVIEW				09/06/2025



THIS DOCUMENT IS THE PROPERTY OF PAYAK POWER CORP. WHO WILL SAFEGUARD ITS RIGHT ACCORDING TO THE CIVIL AND PENAL PROVISION OF THE LAW.

FOR PTT LNG SOLAR ROOFTOP AT ISB AND GIS SUBSTATIONS 200.20kW

TITLE SOLAR SYSTEM SINGLE LINE DIAGRAM

EPCC	PROJ. NO.	DWG. NO.	SHEET
PTTLNG	PPA25.0008	PPA25.0008-PTTLNG-EE-001	3 OF 3
			REV. R3
DISCIP.		SIZE	A3 SCALE NTS

A

B

C