


EC

4


A

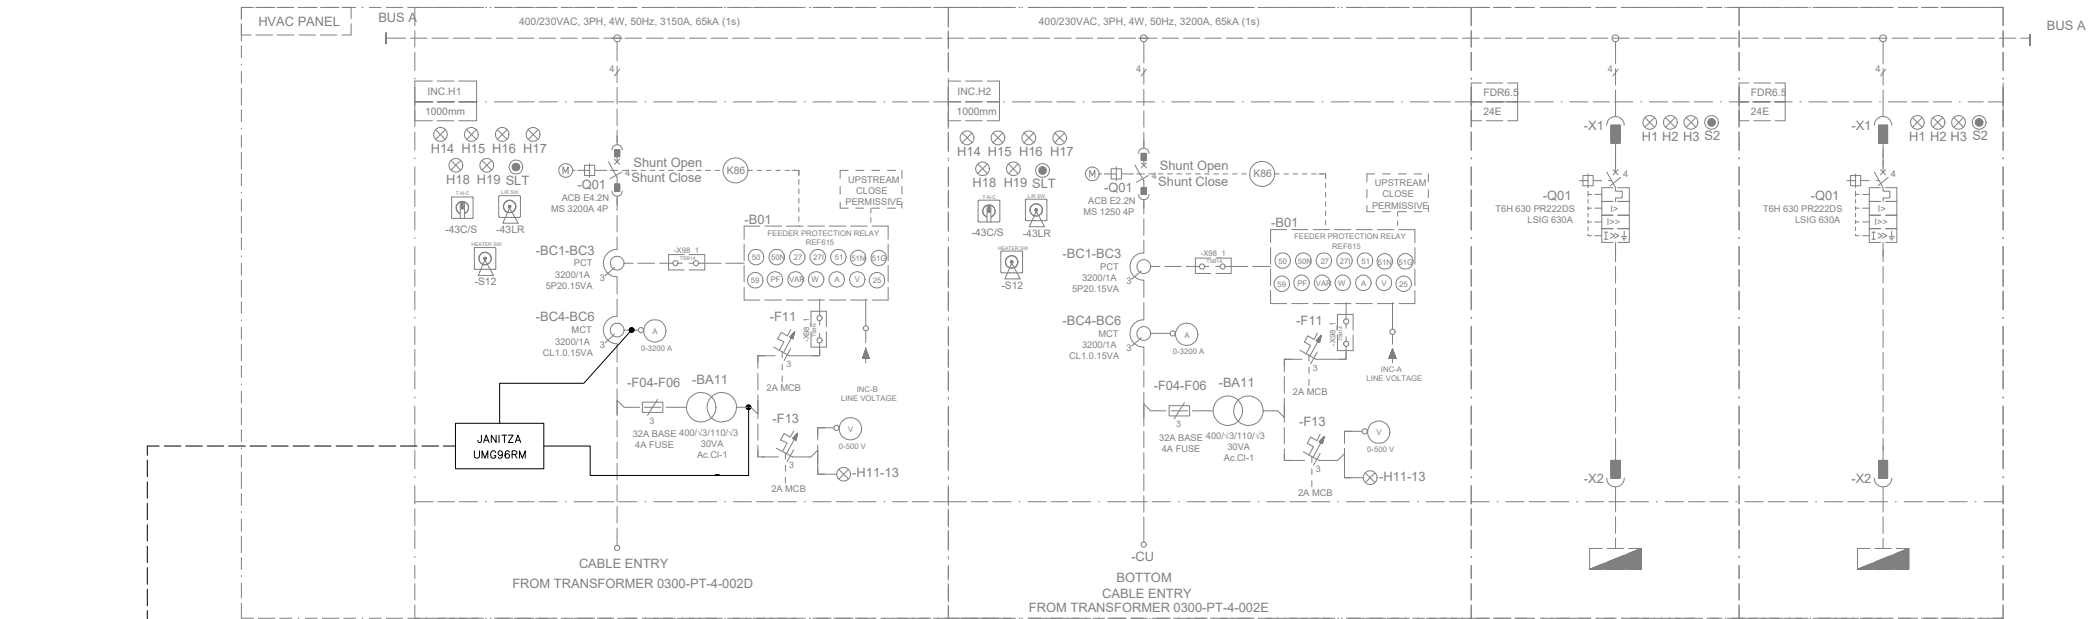

RS485 (SHIELD)
IN RSC 1/2"
TO SMART LOGGER

MODULE LOCATION :	SA01	SA02	SA03G	SA04D
TAG NO. :				
DESCRIPTION :	INCOMING A	Incoming B	FEEDER 630A	FEEDER 630A
RATE POWER (kW) :			520 KVA	520 KVA
RATE CURRENT (A) :	3200A	3200	630	630
LOAD TYPE :	INC	INC	FDR	FDR
ABB TYPE :	INC.H1	INC.H2	FDR6.5	FDR6.5

B

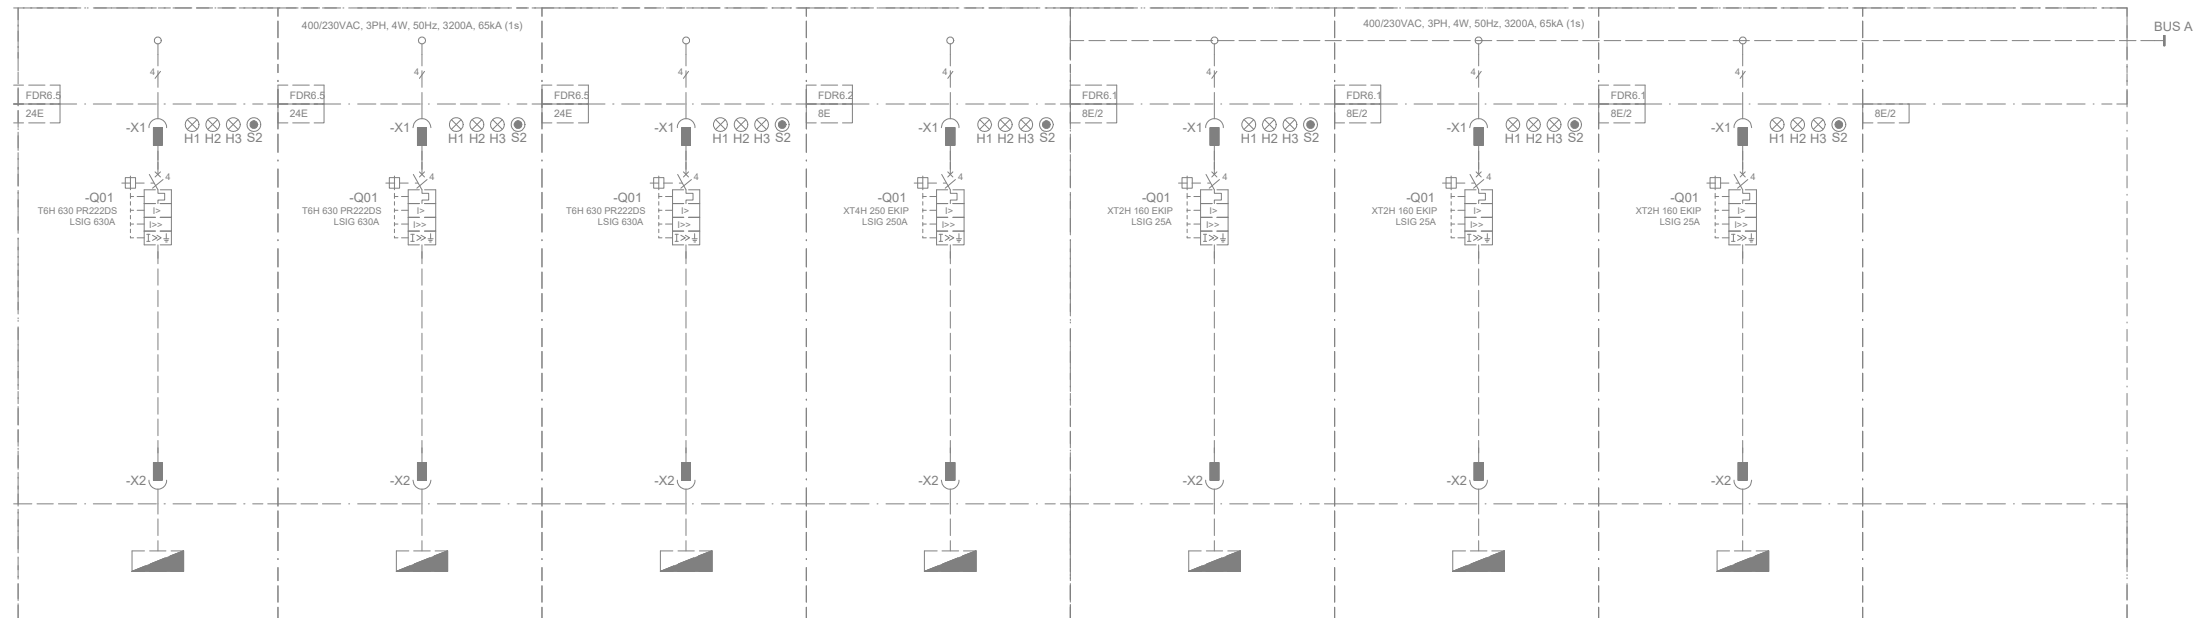

MODULE LOCATION :	SA04G	SA05D	SA05G	SA03F	SA03B1	SA03B3	SA03C1	SA03C3
TAG NO. :								
DESCRIPTION :	FEEDER 630A	FEEDER 630A	FEEDER 630A	FEEDER 250A	FEEDER 25A	FEEDER 25A	FEEDER 25A	RESERV SPACE FOR FEEDER 63A
RATE POWER (kW) :								
RATE CURRENT (A) :	630	630	630	250	25	25	25	
LOAD TYPE :	FDR	FDR	FDR	FDR	FDR	FDR	FDR	
ABB TYPE :	FDR6.5	FDR6.5	FDR6.5	FDR6.2	FDR6.1	FDR6.1	FDR6.1	

C

AS BUILT

B

C

REFERENCE DRAWINGS	DWG. NUMBER

R3	IFA	ISSUE FOR AS BUILT			08/12/2025
R2	IFR	ISSUE FOR REVIEW			01/07/2025
R1	IFR	ISSUE FOR REVIEW			09/06/2025
REV.	STATUS	DESCRIPTION	BY	CHK.	APPR.
					DATE



THIS DOCUMENT IS THE PROPERTY OF PAYAK POWER CORP. WHO WILL SAFEGUARD ITS RIGHT ACCORDING TO THE CIVIL AND PENAL PROVISION OF THE LAW.

FOR PTT LNG SOLAR ROOFTOP AT ISB AND GIS SUBSTATIONS 200.20kW

TITLE SOLAR SYSTEM SINGLE LINE DIAGRAM

EPCC	PROJ. NO.	DWG. NO.	SHEET
PTTLNG	PPA25.0008	PPA25.0008-PTTLNG-EE-001	2 OF 4
			REV. R3
DISCIP.	SIZE	A3	SCALE NTS

R3	IFA	ISSUE FOR AS BUILT				08/12/2025
R2	IFR	ISSUE FOR REVIEW				01/07/2025
R1	IFR	ISSUE FOR REVIEW				09/06/2025
REV.	STATUS	DESCRIPTION	BY	CHK.	APPR.	DATE




THIS DOCUMENT IS THE PROPERTY OF PAYAK POWER CORP WHO WILL SAFEGUARD ITS RIGHT
ACCORDING TO THE CIVIL AND PENAL PROVISION OF THE LAW.

FOR PTT LNG SOLAR ROOFTOP AT
ISB AND GIS SUBSTATIONS 200.20kW

TITLE	SOLAR SYSTEM SINGLE LINE DIAGRAM
-------	----------------------------------

EPCC	PROJ. NO.	DWG. NO.			SHEET
PTTLNG	PPA25.0008	PPA25.0008-PTTLNG-EE-001			3 OF 4
					REV. R3
DISCIP.		SIZE	A3	SCALE	NTS

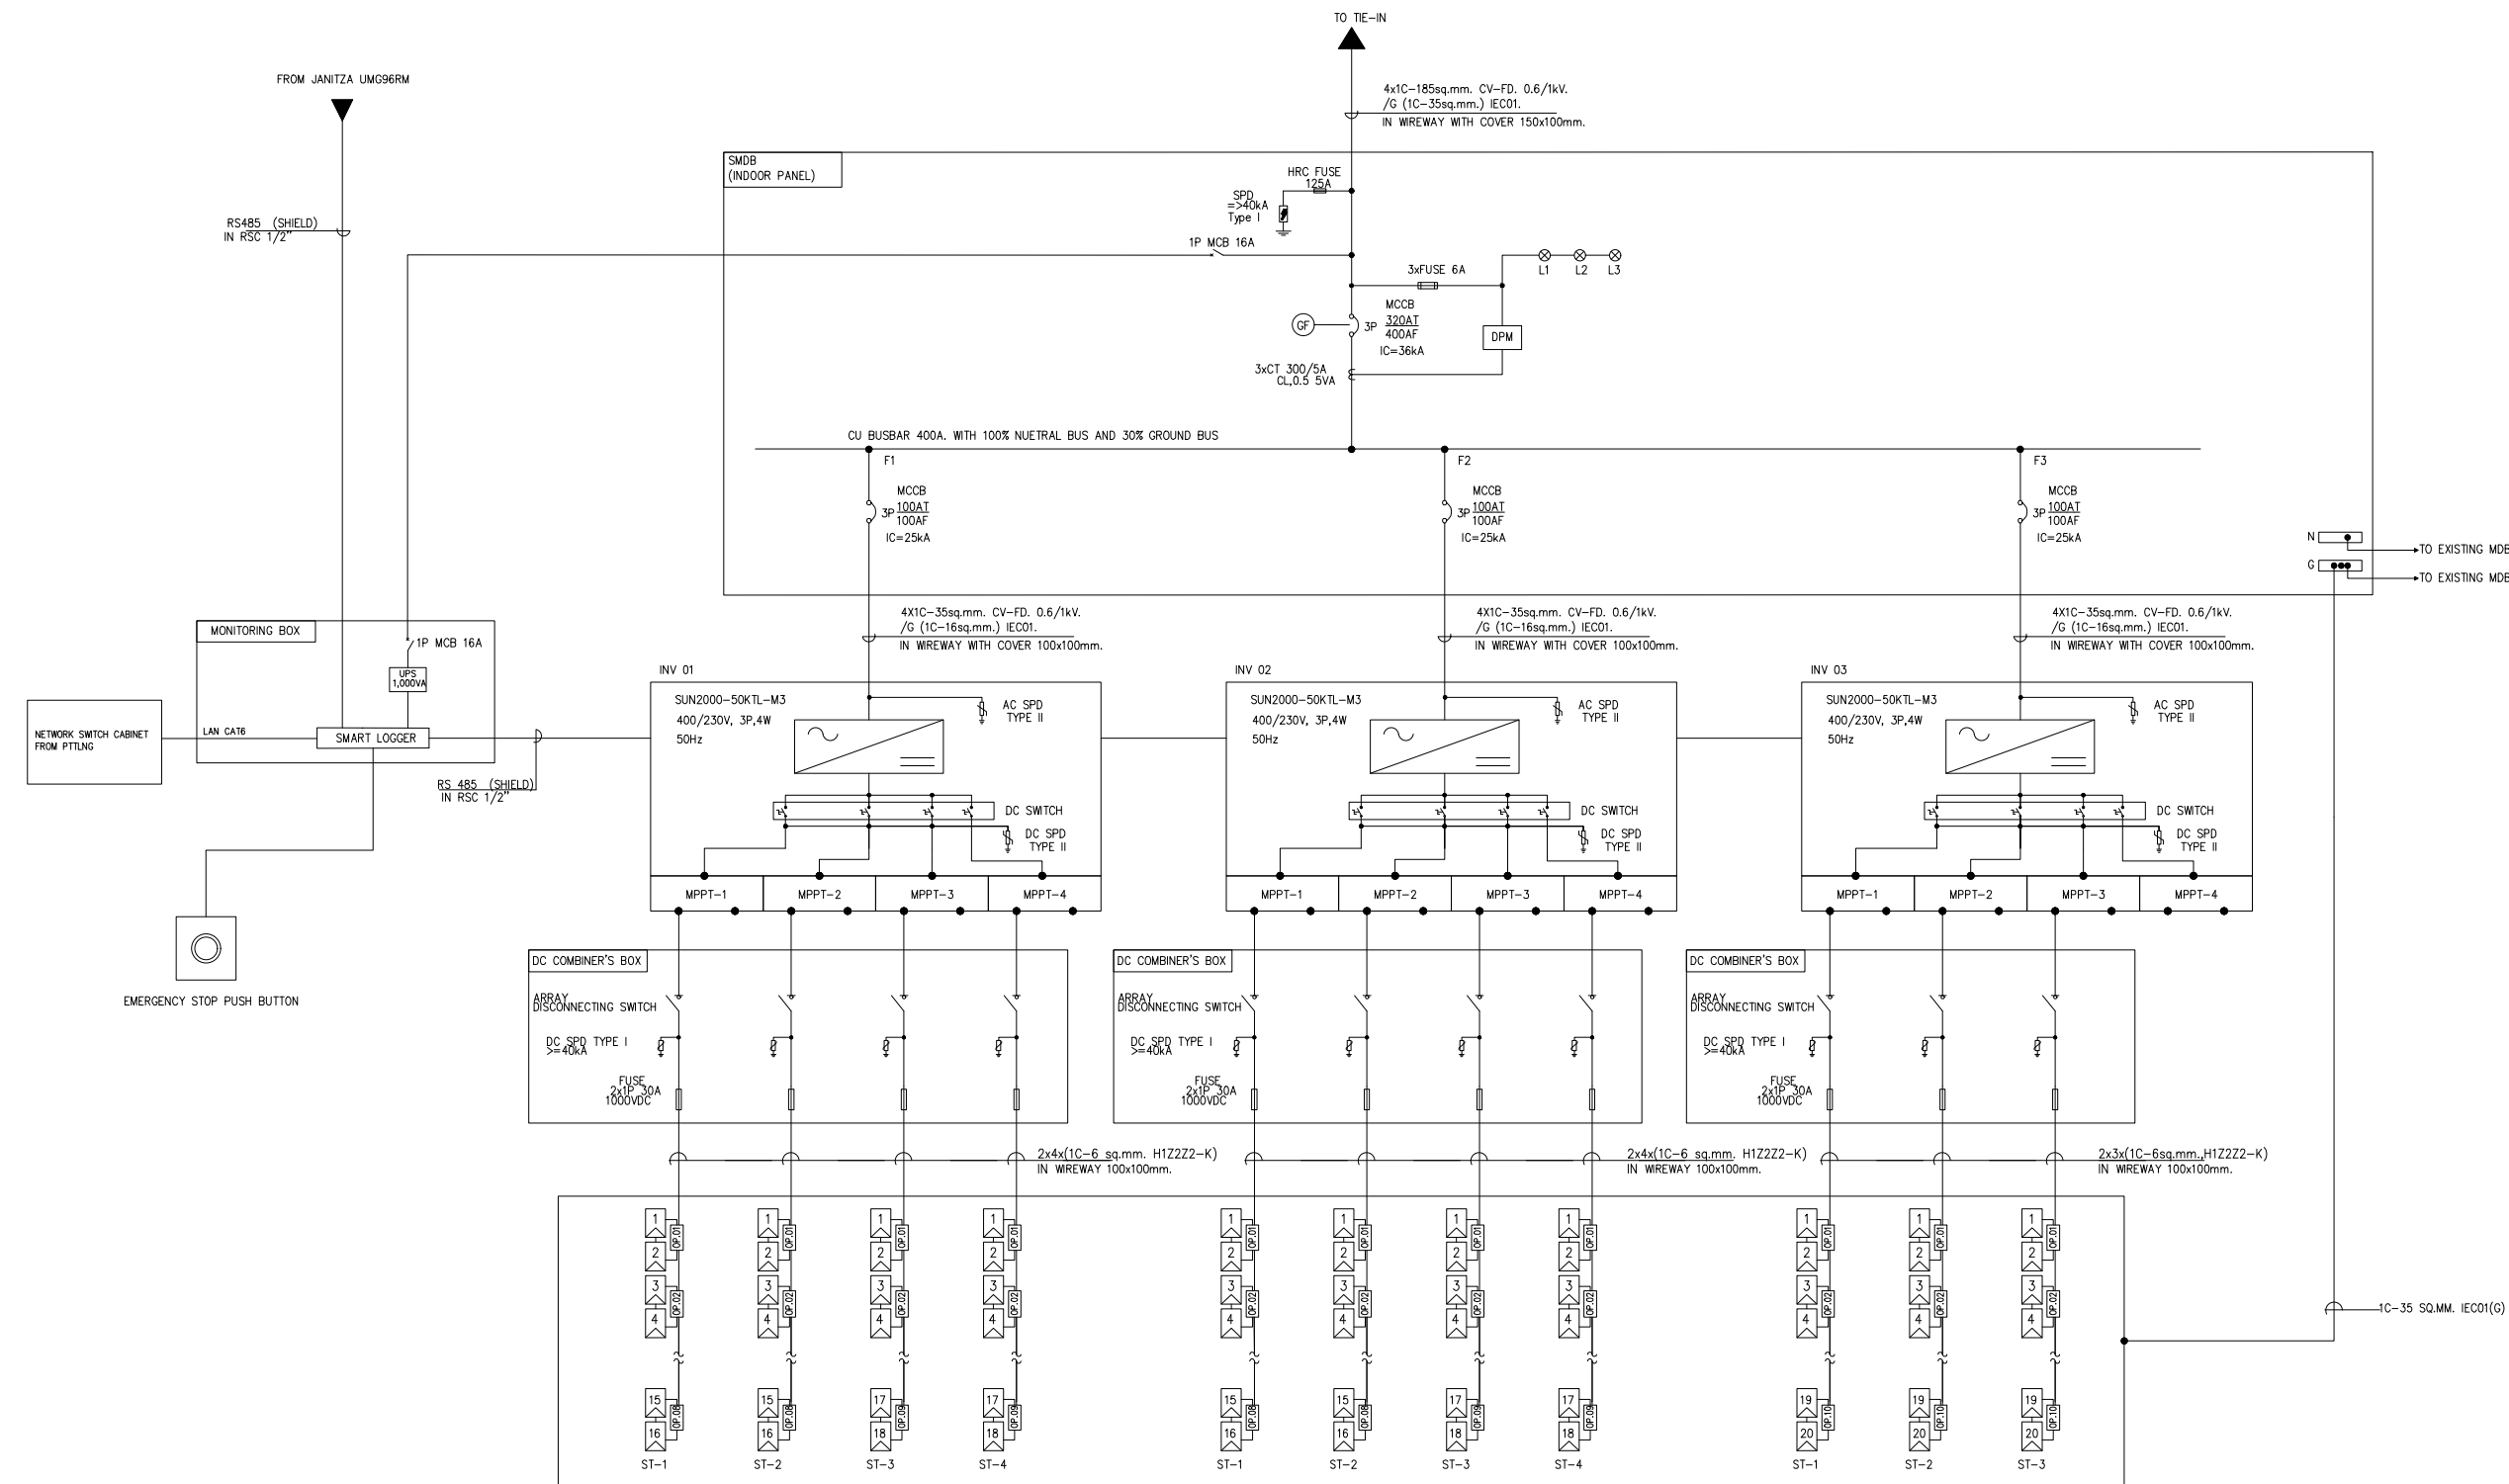

SOLAR ROOFTOP AT ISB	
PV MODULE	TRINA, TSM-NEG21C.20(715 Wp), 196 PCS
INVERTER	HUAWEI, SUN2000-50KTL-M3(50kW), 3 UNITS
POWER OPTIMIZER	HUAWEI, MERC-1300W-P, 98 UNITS
DC CAPACITIES	140.14 kWp.
DC/AC RATIO	0.93

AS BUILT

REFERENCE DRAWINGS	DWG. NUMBER

R3	IFA	ISSUE FOR AS BUILT				08/12/2025
R2	IFR	ISSUE FOR REVIEW				01/01/2025
R1	IFR	ISSUE FOR REVIEW				09/06/2025
REV.	STATUS	DESCRIPTION	BY	CHK.	APPR.	DATE



THIS DOCUMENT IS THE PROPERTY OF PAYAK POWER CORP WHO WILL SAFEGUARD ITS RIGHT
ACCORDING TO THE CIVIL AND PENAL PROVISION OF THE LAW.

FOR PTT LNG SOLAR ROOFTOP AT
ISB AND GIS SUBSTATIONS 200.20kW

TITLE
SOLAR SYSTEM SINGLE LINE DIAGRAM

EPCC	PROJ. NO.	DWG. NO.			SHEET
PTTLNG	PPA25.0008	PPA25.0008-PTTLNG-EE-001			4 OF 4
					REV. R3
DISCIP.		SIZE	A3	SCALE	NTS