


AC

EPCC	PROJ. NO.	DWG. NO.			SHEET
PTTLNG	PPA25.0008	PPA25.0008-PTTLNG-EE-001			3 OF 3
					REV. R3
DISCIP.		SIZE	A3	SCALE	NTS

4

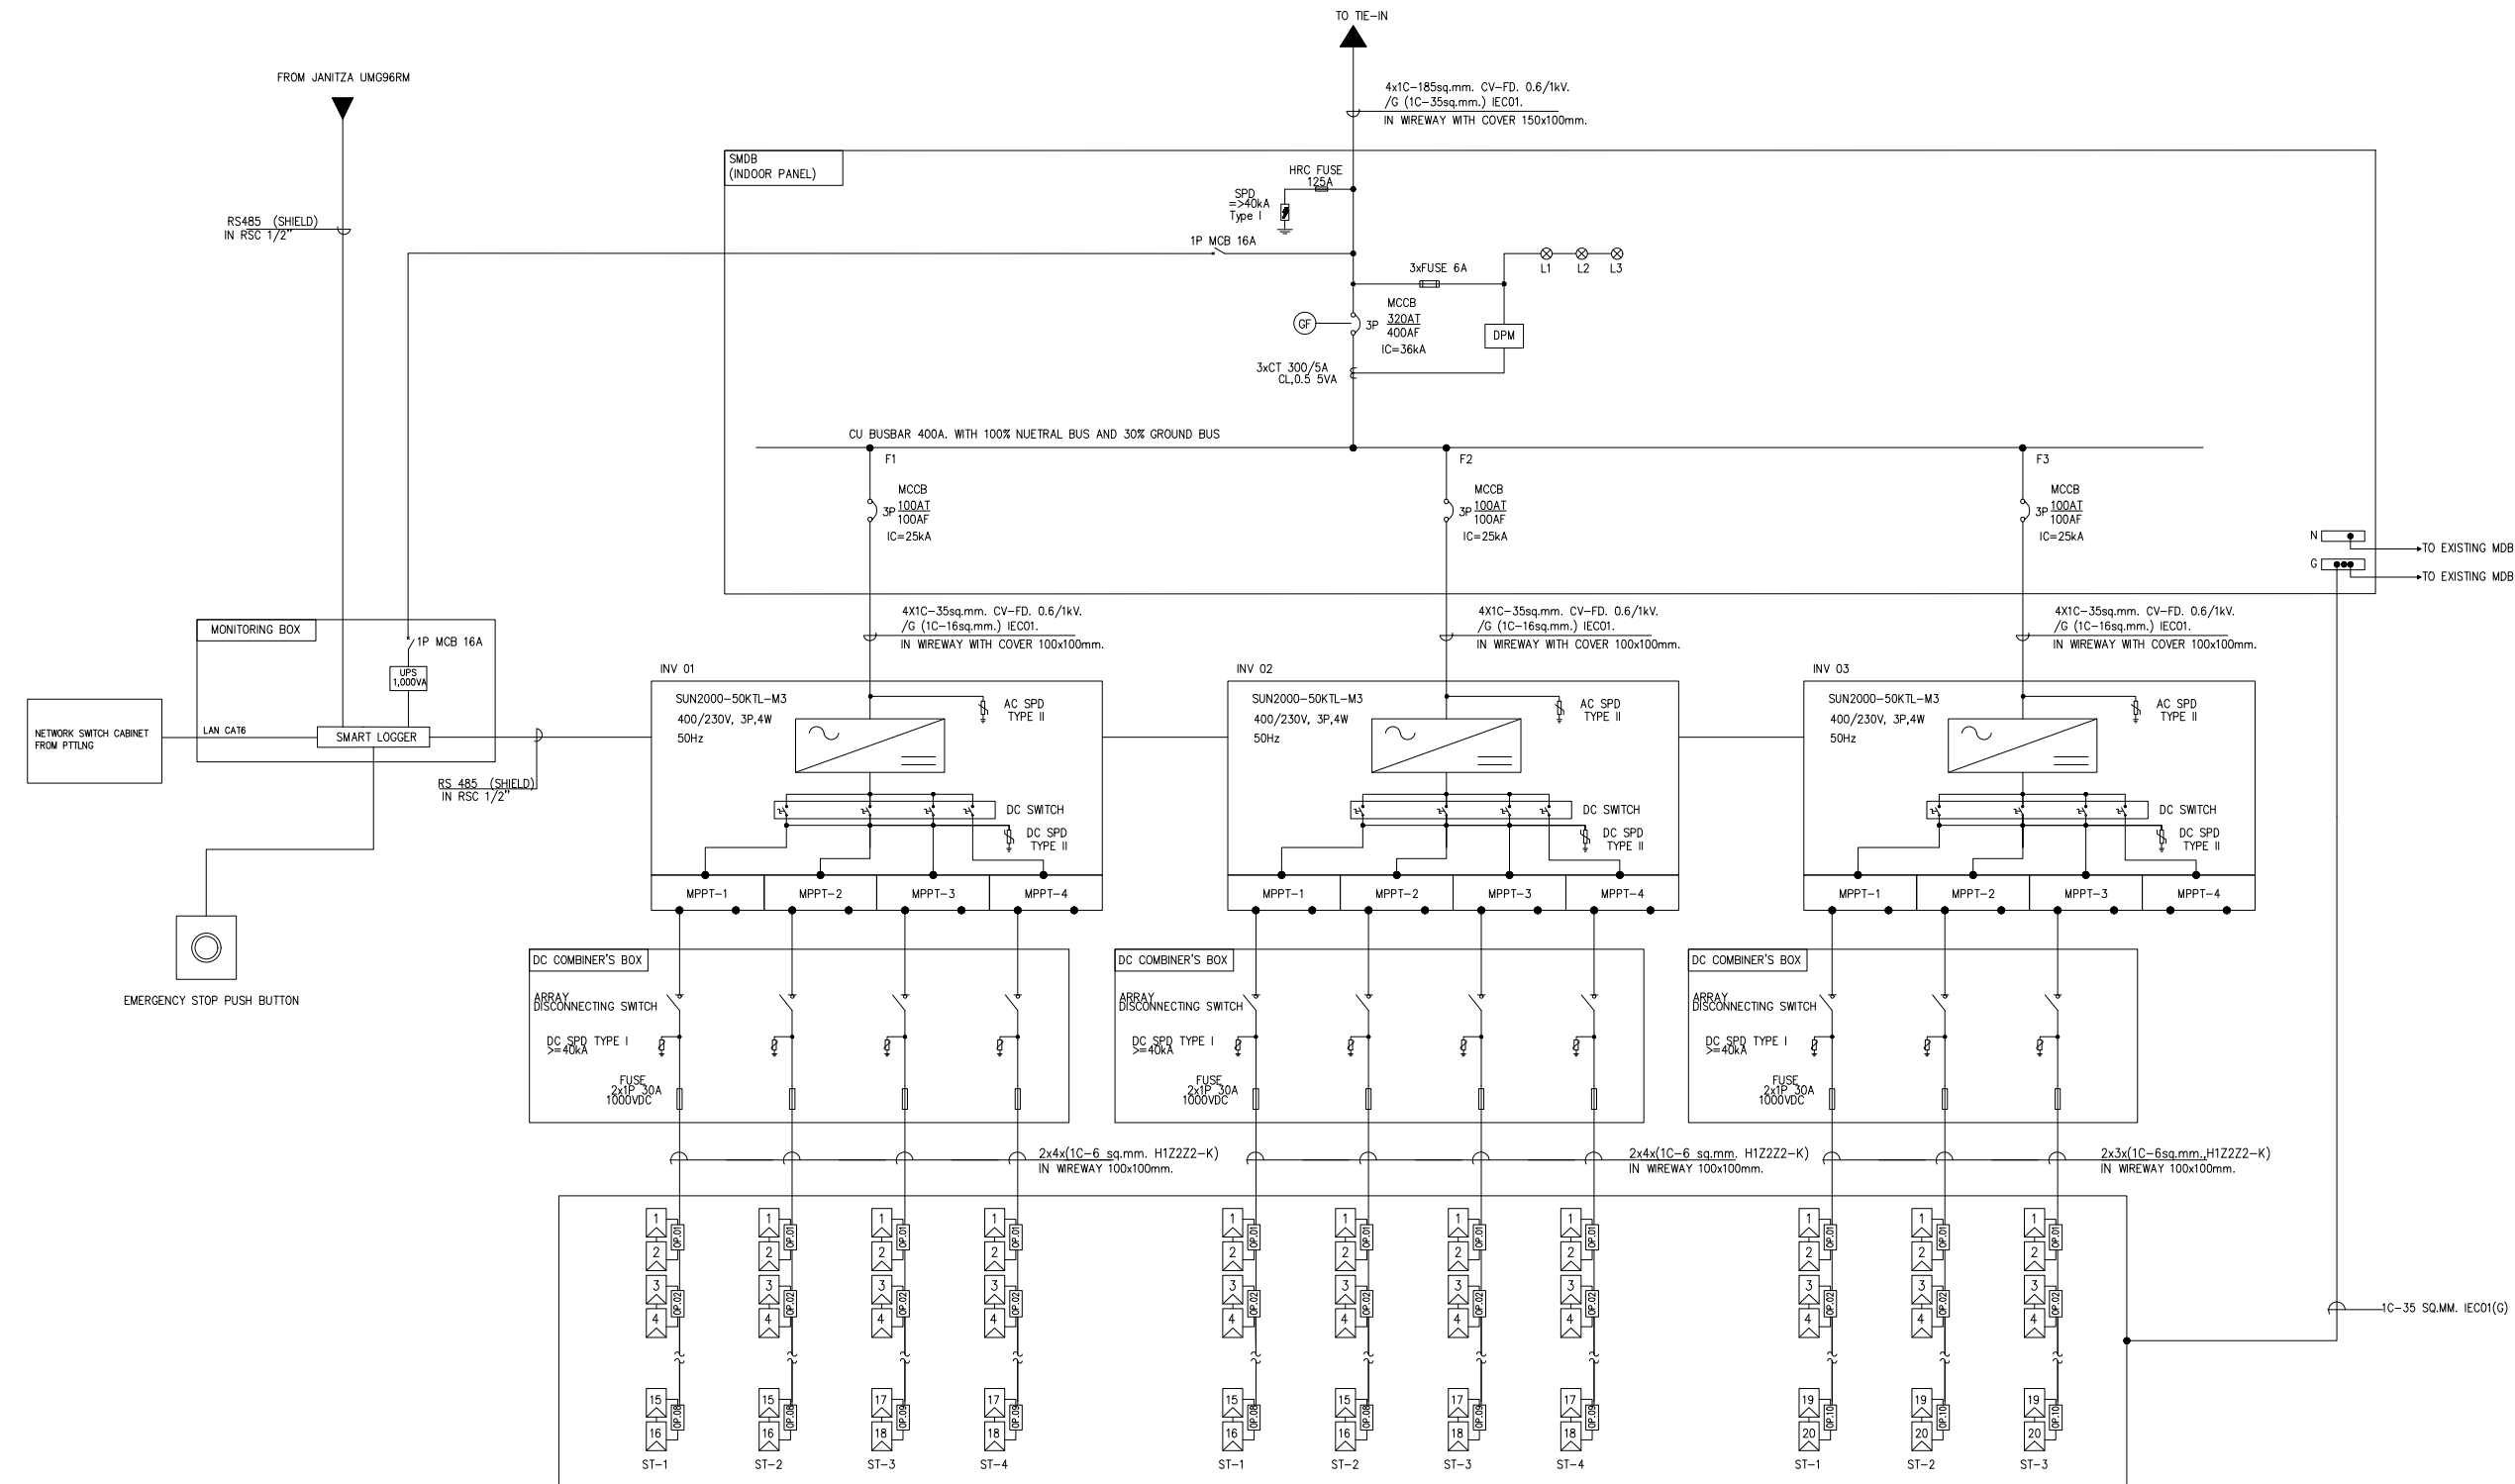

SOLAR ROOFTOP AT ISB	
PV MODULE	TRINA, TSM-NEG21C.20(715 Wp), 196 PCS
INVERTER	HUAWEI, SUN2000-50KTL-M3(50kW), 3 UNITS
POWER OPTIMIZER	HUAWEI, MERC-1300W-P, 98 UNITS
DC CAPACITIES	140.14 kWp.
DC/AC RATIO	0.93

AS BUILT

REFERENCE DRAWINGS	DWG. NUMBER

R3	IFA	ISSUE FOR AS BUILT				08/12/2025
R2	IFR	ISSUE FOR REVIEW				01/01/2025
R1	IFR	ISSUE FOR REVIEW				09/06/2025
REV.	STATUS	DESCRIPTION	BY	CHK.	APPR.	DATE



THIS DOCUMENT IS THE PROPERTY OF PAYAK POWER CORP WHO WILL SAFEGUARD ITS RIGHT
ACCORDING TO THE CIVIL AND PENAL PROVISION OF THE LAW.

FOR PTT LNG SOLAR ROOFTOP AT
ISB AND GIS SUBSTATIONS 200.20kW

TITLE	SOLAR SYSTEM SINGLE LINE DIAGRAM
-------	----------------------------------

EPCC	PROJ. NO.	DWG. NO.			SHEET
PTTLNG	PPA25.0008	PPA25.0008-PTTLNG-EE-001			4 OF 4
					REV. R3
DISCIP.		SIZE	A3	SCALE	NTS